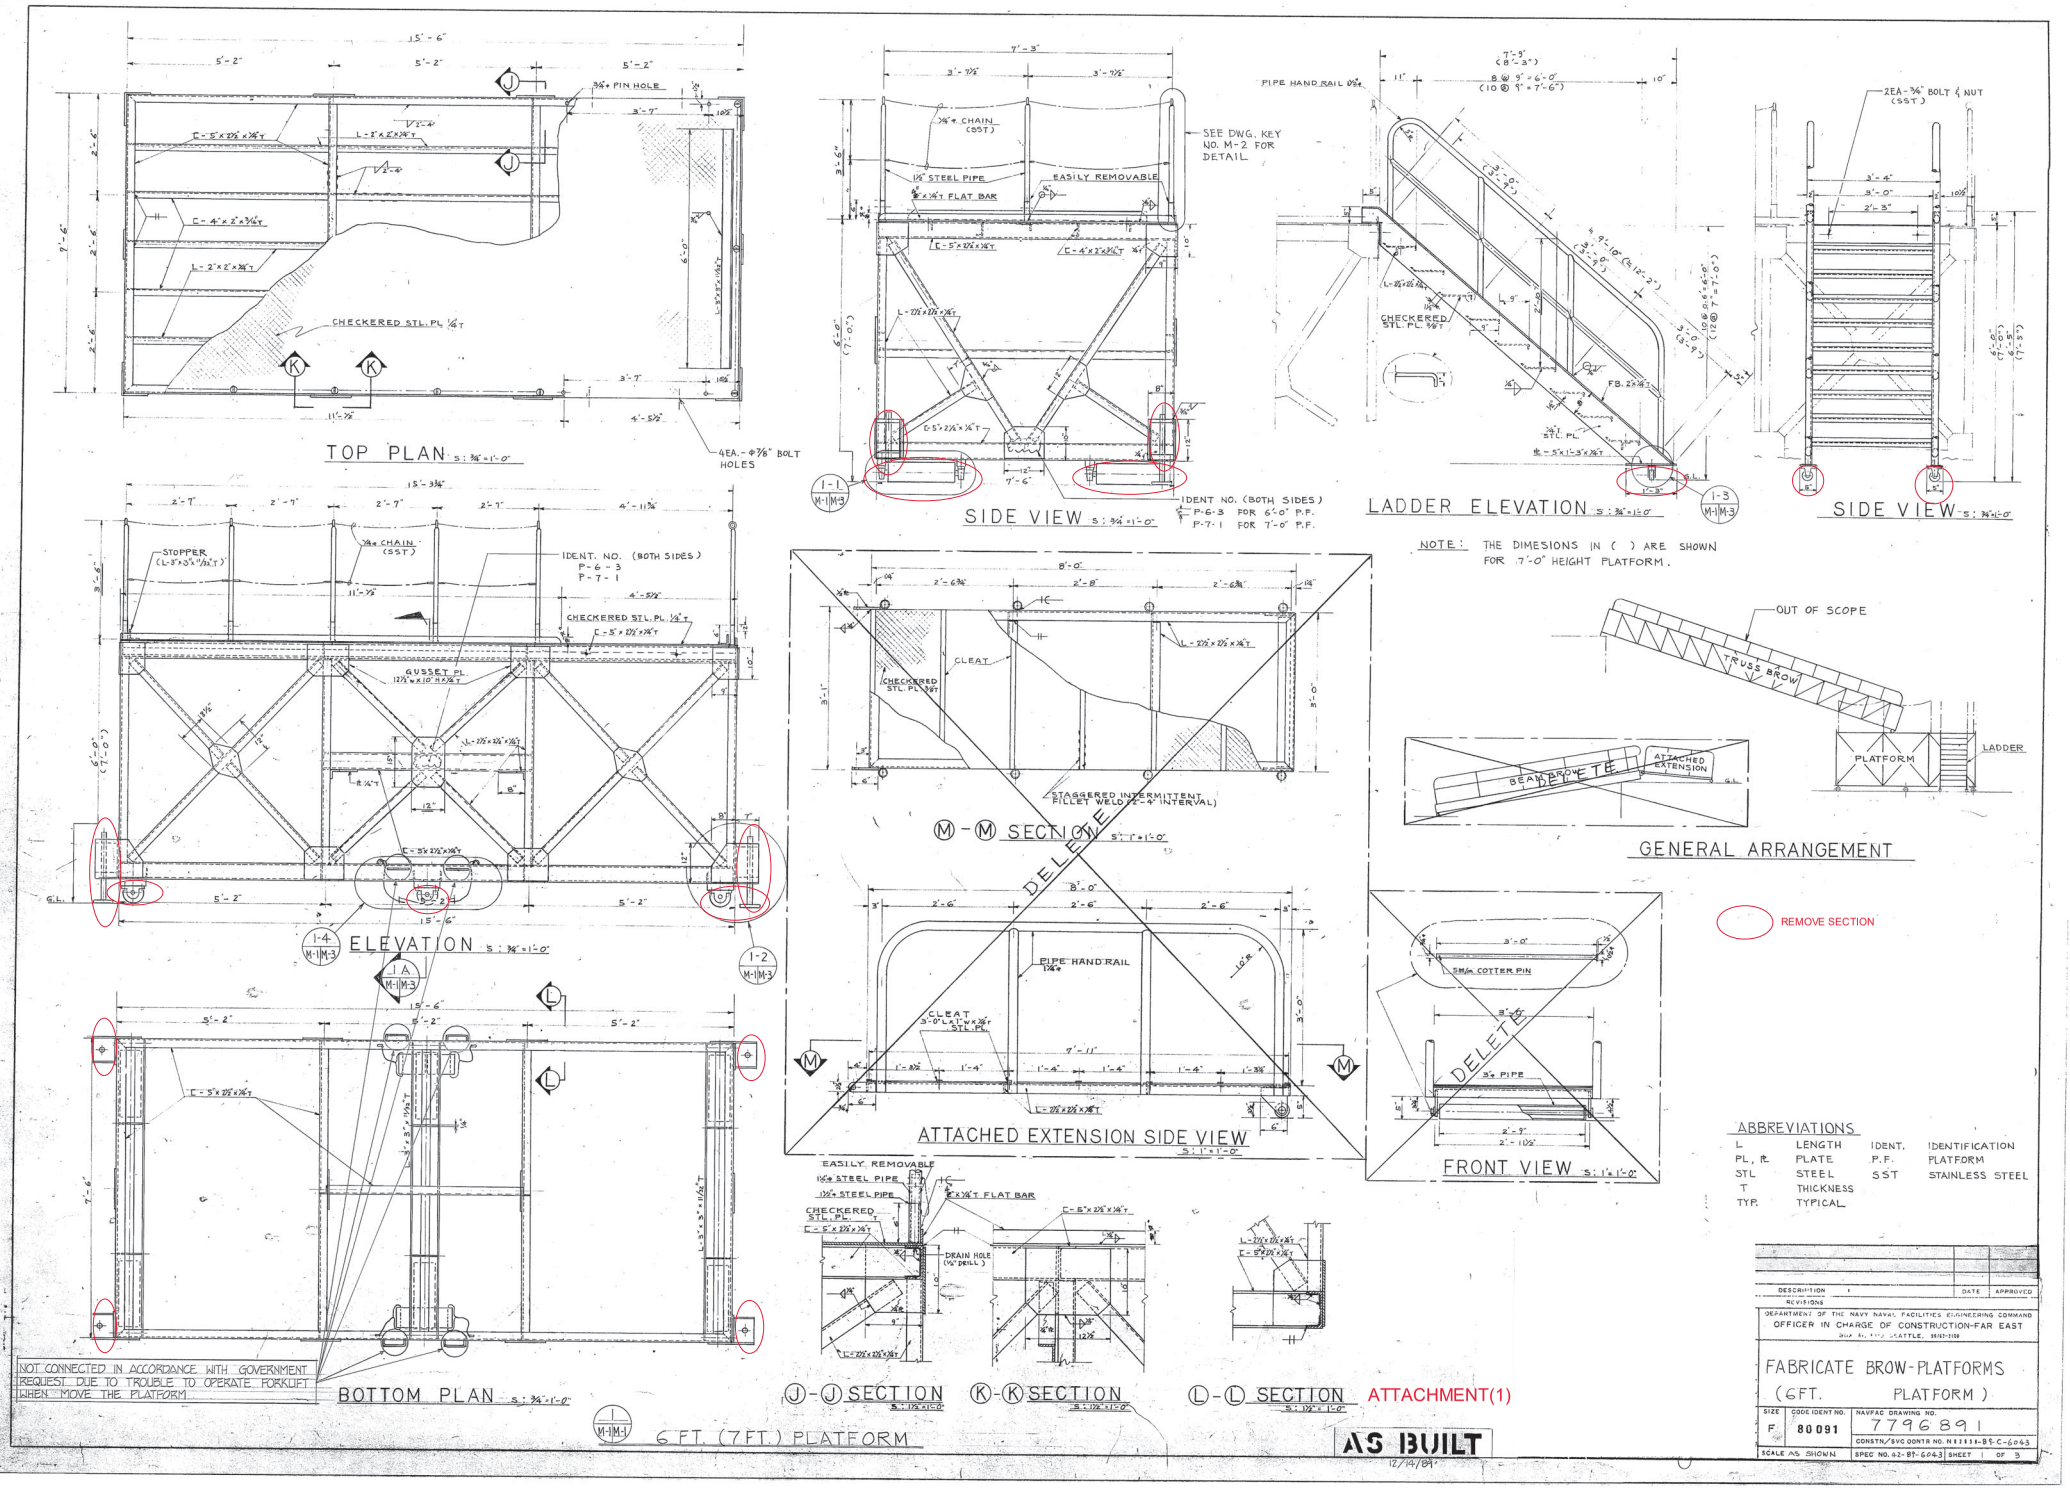
TOP PLAN S: 3/8"=1'-0"
SIDE VIEW S: 3/8"=1'-0"
LADDER ELEVATION S: 3/8"=1'-0"
SIDE VIEW S: 3/8"=1'-0"
ELEVATION S: 3/8"=1'-0"
M-M SECTION S: 1"=1'-0"
GENERAL ARRANGEMENT
ATTACHED EXTENSION SIDE VIEW S: 1"=1'-0"
FRONT VIEW S: 1"=1'-0"
BOTTOM PLAN S: 3/8"=1'-0"
J-J SECTION S: 1 1/2"=1'-0"
K-K SECTION S: 1 1/2"=1'-0"
L-L SECTION S: 1 1/2"=1'-0"
6 FT. (7 FT.) PLATFORM
NOTE: THE DIMESIONS IN ( ) ARE SHOWN FOR 7'-0" HEIGHT PLATFORM.
REMOVE SECTION
ATTACHMENT(1)
AS BUILT
12/14/89
NOT CONNECTED IN ACCORDANCE WITH GOVERNMENT REQUEST DUE TO TROUBLE TO OPERATE FORKLIFT WHEN MOVE THE PLATFORM.
ABBREVIATIONS
L LENGTH
PL, PL. PLATE
STL STEEL
T THICKNESS
TYP. TYPICAL
IDENT. IDENTIFICATION
P.F. PLATFORM
SST STAINLESS STEEL
DEPARTMENT OF THE NAVY NAVAL FACILITIES ENGINEERING COMMAND
OFFICER IN CHARGE OF CONSTRUCTION-FAR EAST
FABRICATE BROW-PLATFORMS
(6FT. PLATFORM)
CODE IDENT NO. 80091
NAVFAC DRAWING NO. 7796891
SCALE AS SHOWN
SPEC NO. 42-87-6043
SHEET 1 OF 3